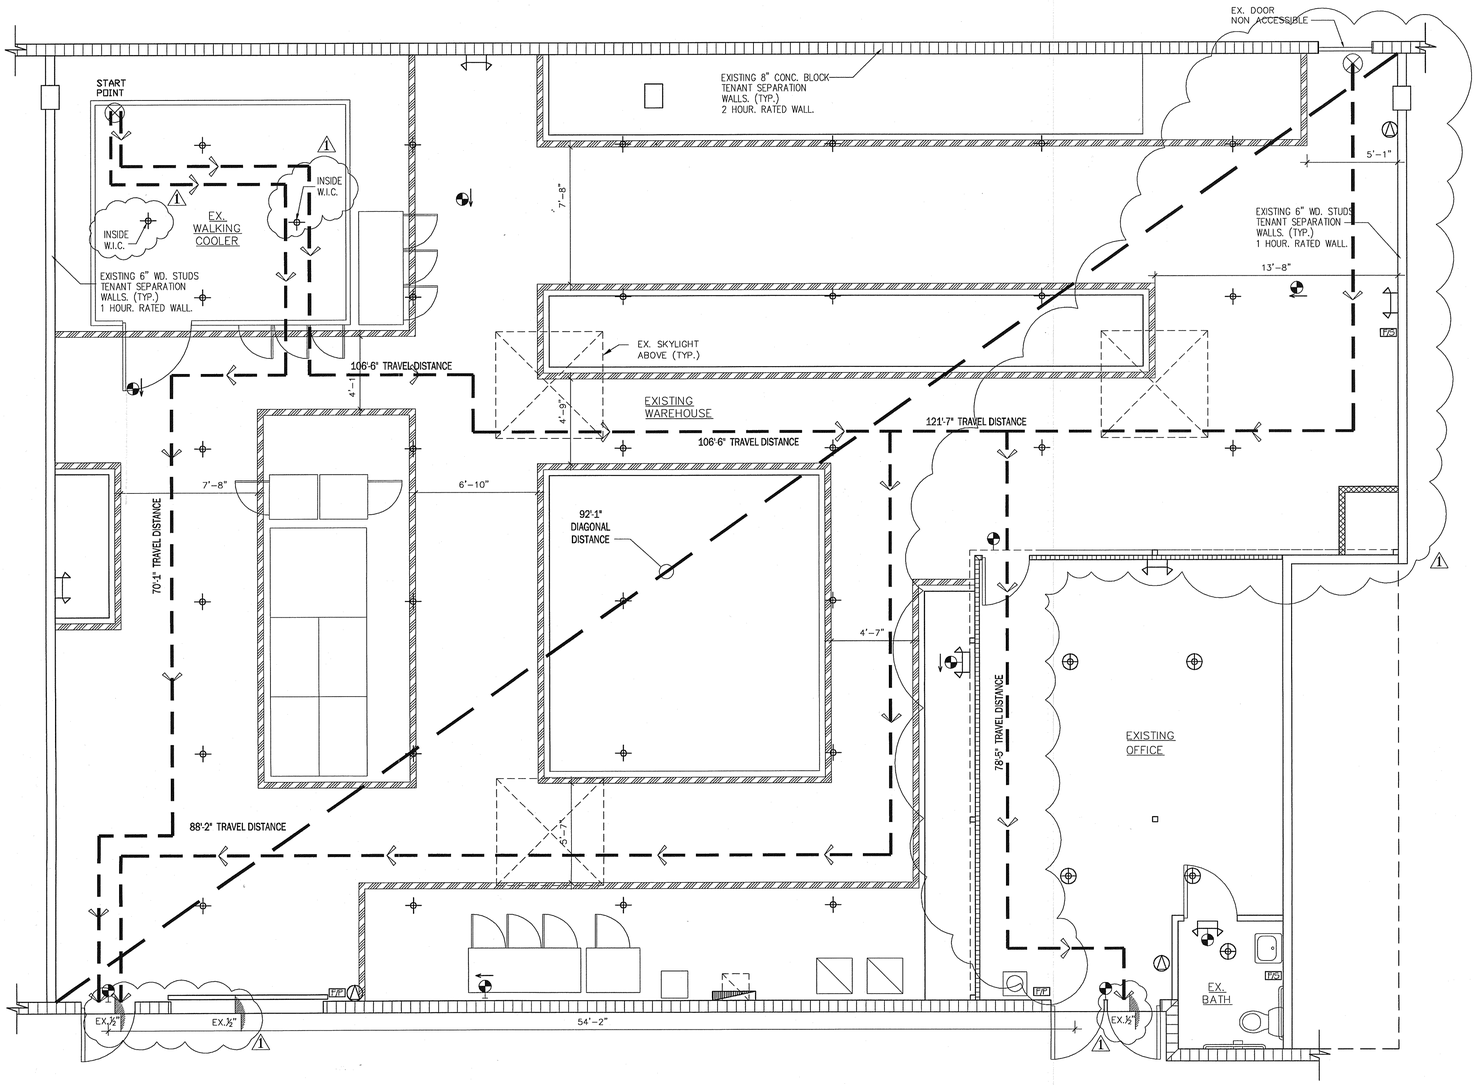

LIFE SAFETY PLAN

SCALE: 1/4"=1'-0"

SYMBOL LEGEND

- EX. SPRINKLER HEAD TO REMAIN
- NEW SPRINKLER HEAD @ EX. LOCATION
- FIRE STROBE SPEAK
- FIRE PULL
- EMERGENCY LIGHT
- EXIT SIGN
- EXTINGUISHER
- PROTECTED STORAGE AREA

SPRINKLER NOTE:

FULL SPRINKLED BUILDING SYSTEM. ALL EXISTING SPRINKLER HEAD TO REMAIN. NO SPRINKLER WORK REQUIRED

FIREALARME NOTE:

EXISTING FIRE ALARM SYSTEM TO REMAIN. ALL EXISTING ALARM DEVICES TO REMAIN. NO FIRE ALARM WORK REQUIRED

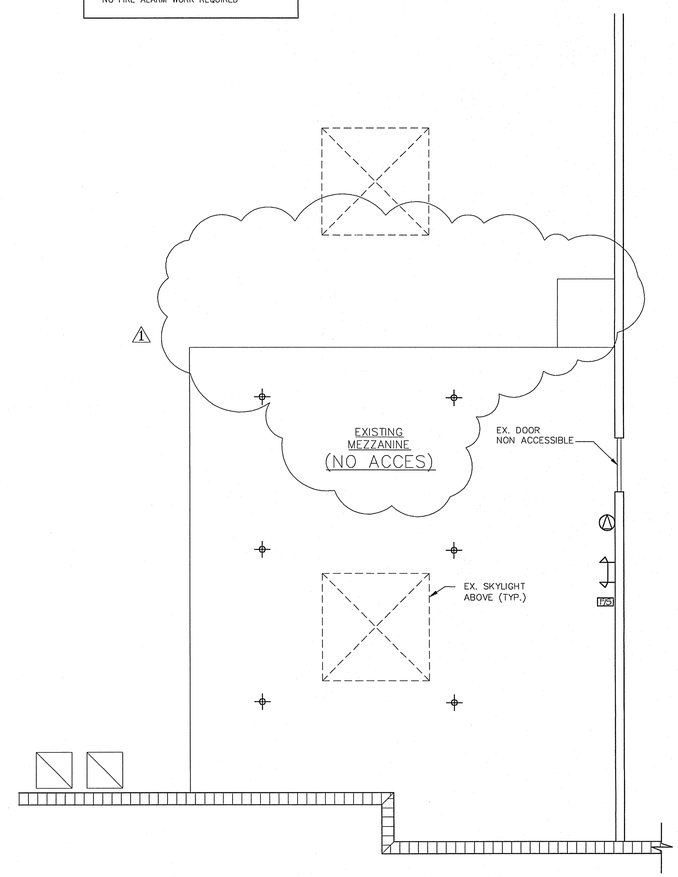

MEZZANINE LIFE SAFETY PLAN

SCALE: 1/4"=1'-0"

RICHARD CORTES
ARCHITECT
AR# 0014236

7700 SW 115 ST
PINECREST, FL. 33156

PH: 305 233-0858
FAX: 305 233-4858
rcortespa@aol.com

SEAL

AS-BUILT/LEGALIZATION FOR:
PACKING CENTER FOR
NOVIS PHARMACEUTICALS
5000 SW 75 AVE.
MIAMI, FL 33155

SHEET NAME:
MECHANICAL PLAN

	SYM	REVISION-RECORD
06/08/12	1	

DATE: 11-03-11

DRAWN BY: LR.

SCALE: ¼" = 1'-0"

PROJECT N°:

NORTH

SHEET No. LS-1

Miami Dade County Department of Permitting, Environment and Regulatory Affairs
0000840496 - 6/27/2012 5:11:00 PM
LS-1-06142012.PDF

Examiner	Date Time Stamp	Disp.	Trade	Stamp Name
Antonio Cantillo	6/19/2012 9:06:00 AM	D	BLDG	Disapproved