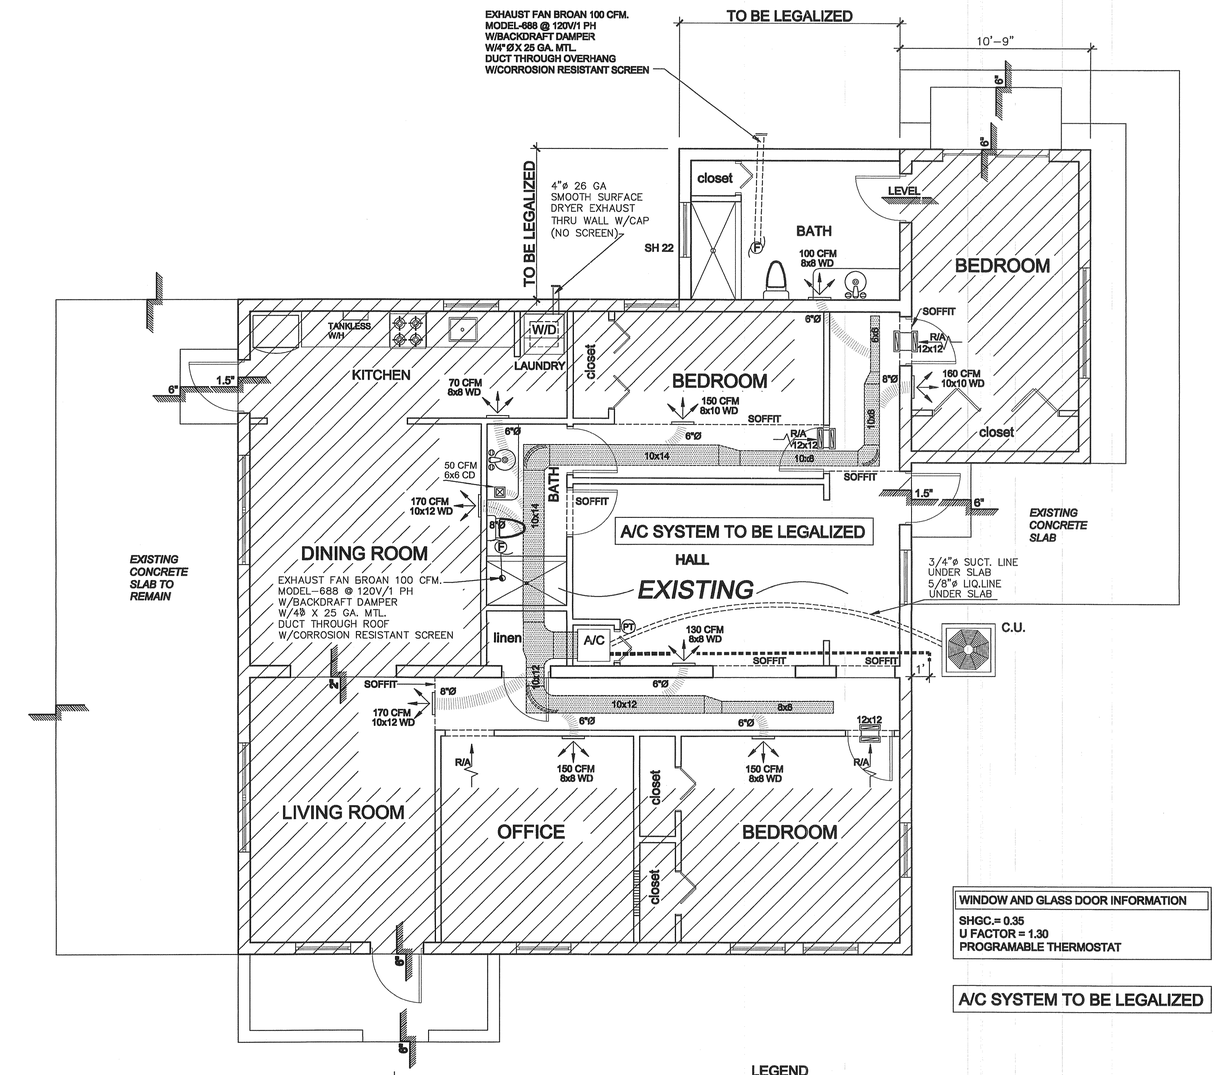

WINDOW AND GLASS DOOR INFORMATION
SHGC.= 0.35
U FACTOR = 1.30
PROGRAMABLE THERMOSTAT

A/C SYSTEM TO BE LEGALIZED

HVAC PLAN

SCALE: 1/4" = 1'- 0"

THE CONSTRUCTION DOCUMENTS HAVE BEEN PREPARED IN COMPLIANCE WITH FBC 2014, 5TH EDITION

LEGEND

- EXISTING PARTITIONS TO REMAIN
- PARTITIONS TO BE LEGALIZED
- EXISTING C.B.S. WALLS TO REMAIN
- C.B.S. WALLS TO BE LEGALIZED

FERMIN A. MARTINEZ, P.E.
CONSULTING ENGINEER
FL. P.E. No 19363
8340 S.W. 65th AVENUE UNIT 3
MIAMI, FLORIDA 33143
TEL. (305) 296-3216

Project Title:
AS BUILT PLANS FOR DEMOLITION/LEGALIZATION OF
ELLAWISH LLC II

Address:
2419 N.W. 99th STREET
MIAMI, FL. 33147

This Sheet:

THESE DRAWINGS AND DESIGNS ARE THE PROPERTY OF FERMIN A. MARTINEZ P.E. AND SHALL NOT BE REPRODUCED WITHOUT HIS WRITTEN CONSENT.

REVISIONS

1	18-04-16

DESCRIPTION

Project No.
15-57
Date:
07-12-15
Drawn By:
PEDRO PUERTO/ CBS (305) 262 8075
Approved By:
F.A.M.

SEAL

FERMIN A. MARTINEZ
LICENSE
No. 19363
STATE OF FLORIDA
PROFESSIONAL ENGINEER

SHEET NO.

M-1

Miami Dade County Department of Regulatory And Economic Resources
0000331469 - 7/20/2016 1:18:07 PM
M-1-05042016.PDF
Examiner Date Time Stamp Disp. Trade Stamp Name
Gloria Garcia 5/5/2016 10:19:59 AM A MECH Approved