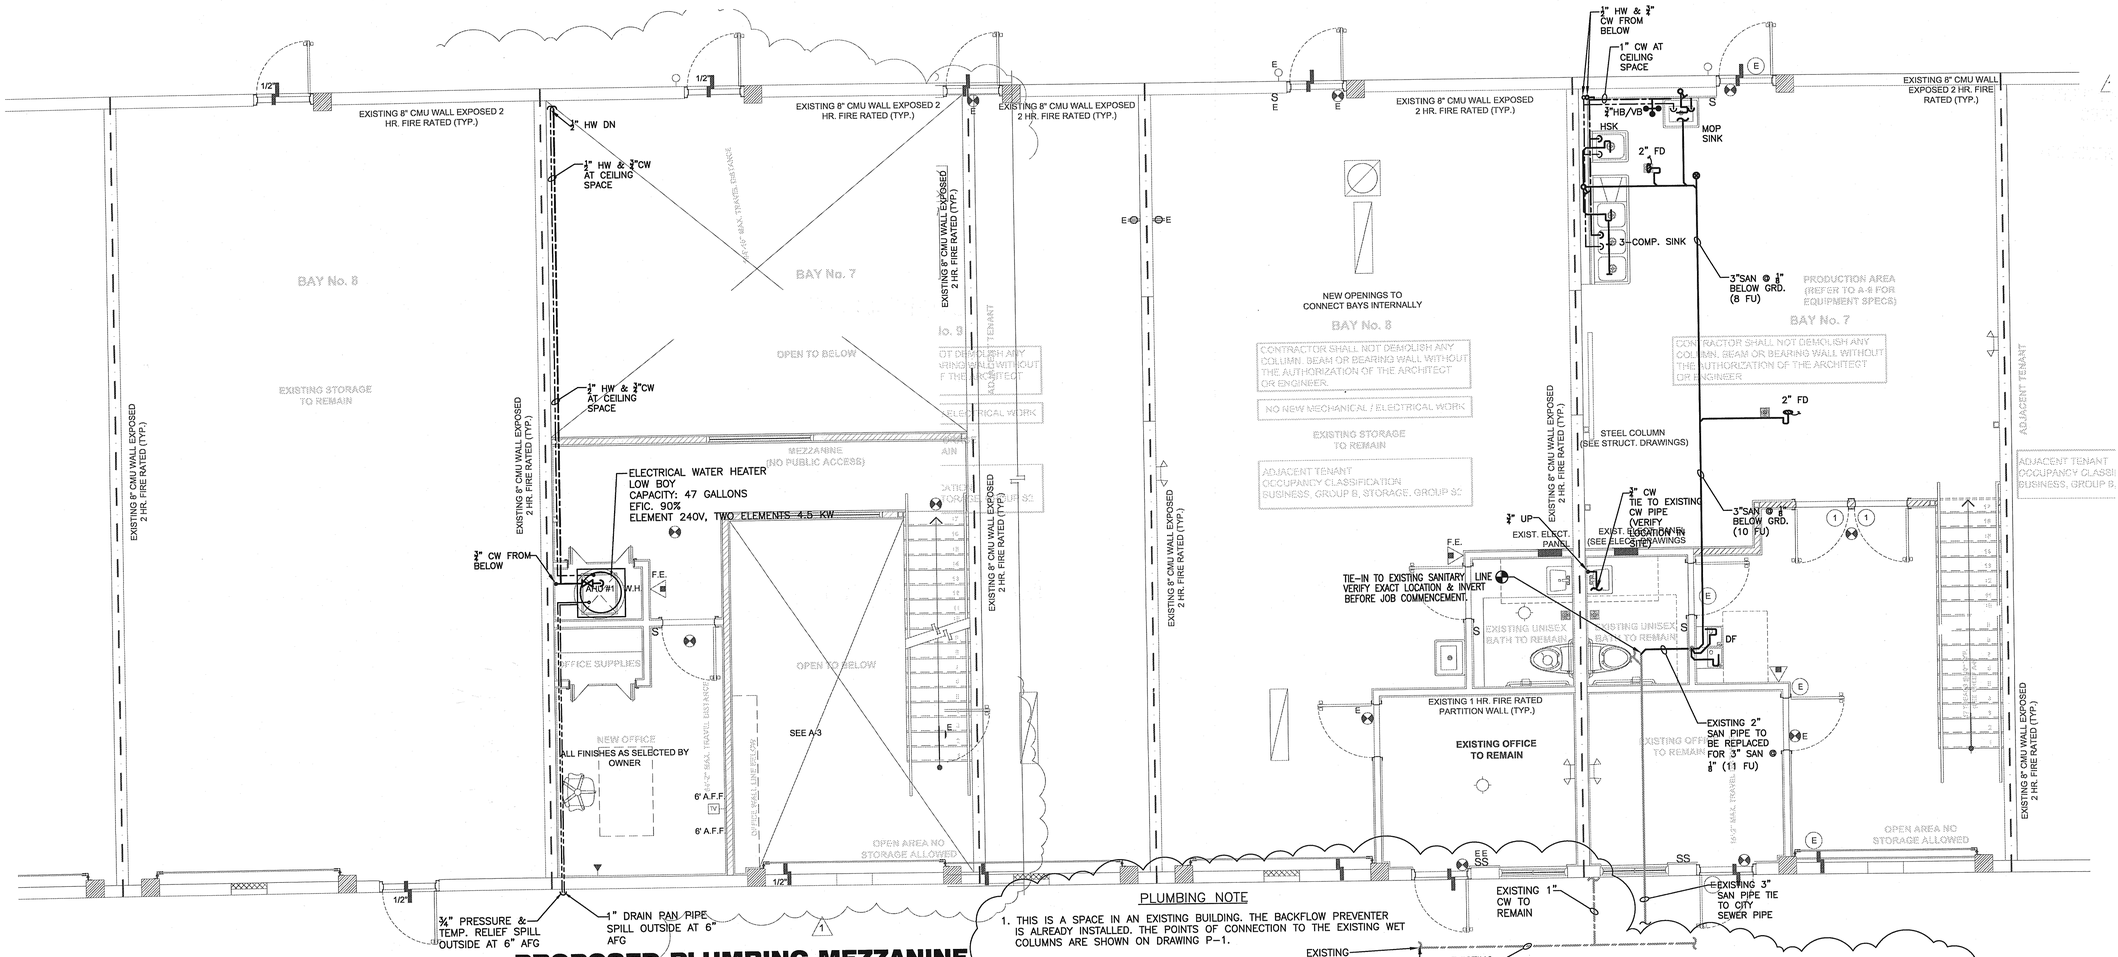

PROPOSED PLUMBING MEZZANINE FLOOR PLAN

SCALE: 1/4"=1'-0"

PROPOSED PLUMBING GROUND FLOOR PLAN

SCALE: 1/4"=1'-0"

PLUMBING NOTE

1. THIS IS A SPACE IN AN EXISTING BUILDING. THE BACKFLOW PREVENTER IS ALREADY INSTALLED. THE POINTS OF CONNECTION TO THE EXISTING WET COLUMNS ARE SHOWN ON DRAWING P-1.

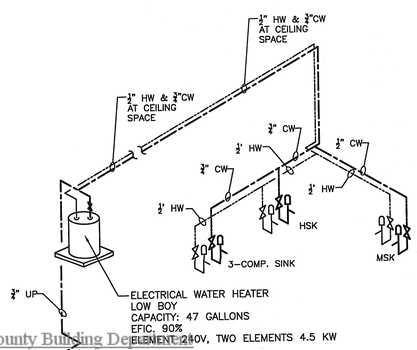

CW & HW ISOMETRIC

N.T.S.

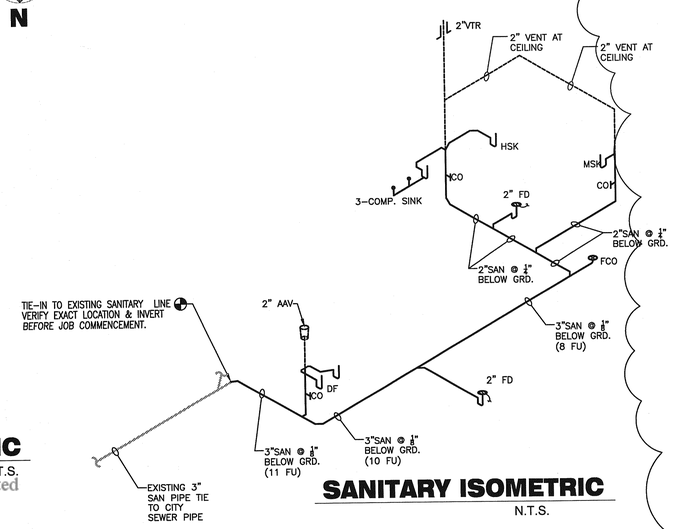

SANITARY ISOMETRIC

N.T.S.

NOTE: (F.B.C. 109.3.6.4.4) "TO THE BEST OF THE ARCHITECT'S KNOWLEDGE, THE PLANS AND SPECIFICATIONS COMPLY WITH THE APPLICABLE MINIMUM BUILDING CODES AND THE APPLICABLE FIRE-SAFETY STANDARDS AS DETERMINED BY THE LOCAL AUTHORITY IN ACCORDANCE WITH THIS SECTION AND CHAPTER 633 OF THE FLORIDA STATUES."

Miami Dade County Building Dep
0000702189 - 2/10/2011 10:33:45 AM
P-1 -01261011.pdf

Examiner	Date Time	Disp.	Trade	Stamp Name
Francisco Borges	1/27/2011 11:31:35 AM	P	PLUM	Approved As Noted
Francisco Borges	2/1/2011 4:15:17 PM	V	PLUM	Void

DESIGN TEAM:

JULIO PULIDO, AIA
ARCHITECTURE - PLANNING
12721 S.W. 30 ST. MIAMI, FL 33175
PH: (305) 505-6910 - AR93904

RMG Engineering Inc.
CONSULTING ENGINEERS
2000 NW. 89th Pl, Suite 135
Doral, FL 33172
Tel. (305) 418-0065
Cel. (305) 310-0577
Fax. (305) 468-3537
rmgeng@bellsouth.net
C.A. # 27319
Maria Z. Guardo P.E. # 60100
Rolando Guardo P.E. # 61028

MES
MIAMI ENGINEERING SERVICES
5665 WEST 20 AVE, # 315 HIALEAH, FL 33012
PHONE: 305 556 2542 CA 27354
mes@miamiesinc.com http://www.miamiesinc.com

PROJECT:

OWNER:
FRANK CHACON
16215 SW 117 AVENUE
UNITS 8A AND 9A
MIAMI, FL 33177

PROJECT:
AGROCAMPO CHACON
SPICES RE-PACKAGING
16215 SW 117 AVENUE
UNITS 7A, 8A AND 9A
MIAMI, FL 33177

MANAGEMENT:

#	REVISIONS	DATE
1	BLDG. DEPARTMENT COMMENTS	12.15.10

DATE :	OCTOBER 30, 2010
PROJECT No. :	030-10
DRAWN BY:	L.P.
CHECKED BY:	J.P.

SHEET TITLE:

PROPOSED PLUMBING FLOOR PLAN

SHEET No:

P-1