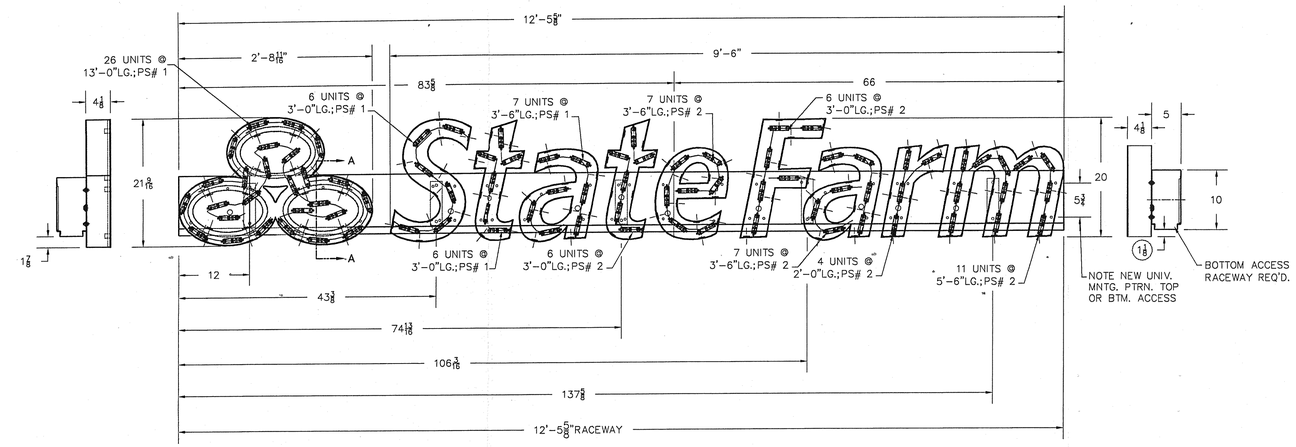

ELEVATION
SCALE: 1"= 1'-0"

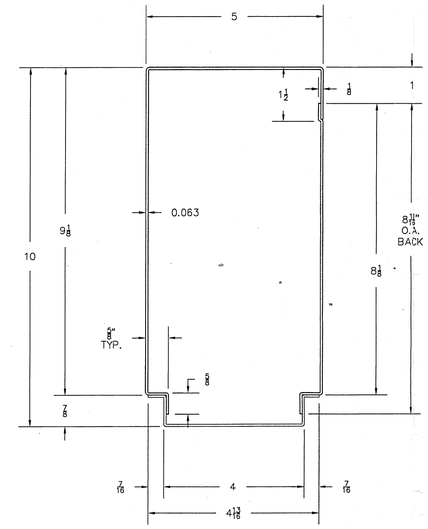

RACEWAY DETAIL
.063 ALUM., 2-PC. CONSTR.

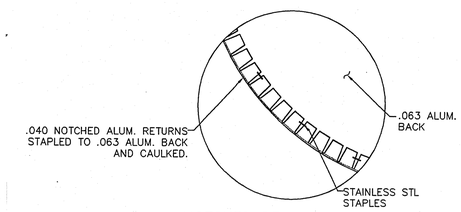

NOTCHED RETURN DETAIL
PARTIAL REAR ELEVATION

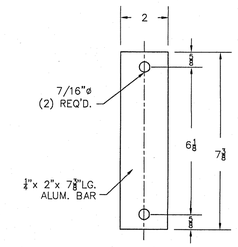

RACEWAY MNTG. STRAP
(CONCEALED MNTG.)
WELDED INTERNALLY

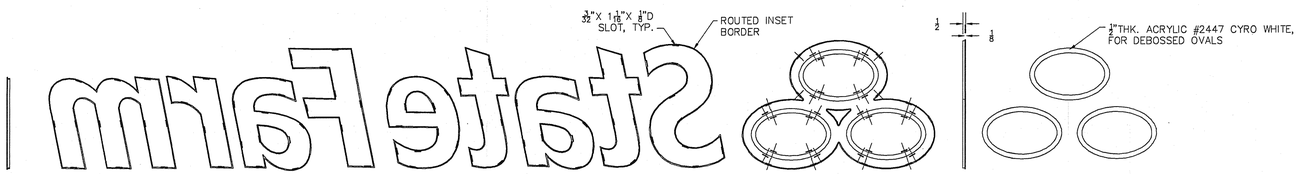

REAR VIEW / LETTER FACES
1/2"THICK, WHITE #2447 CYRO ACRYLIC

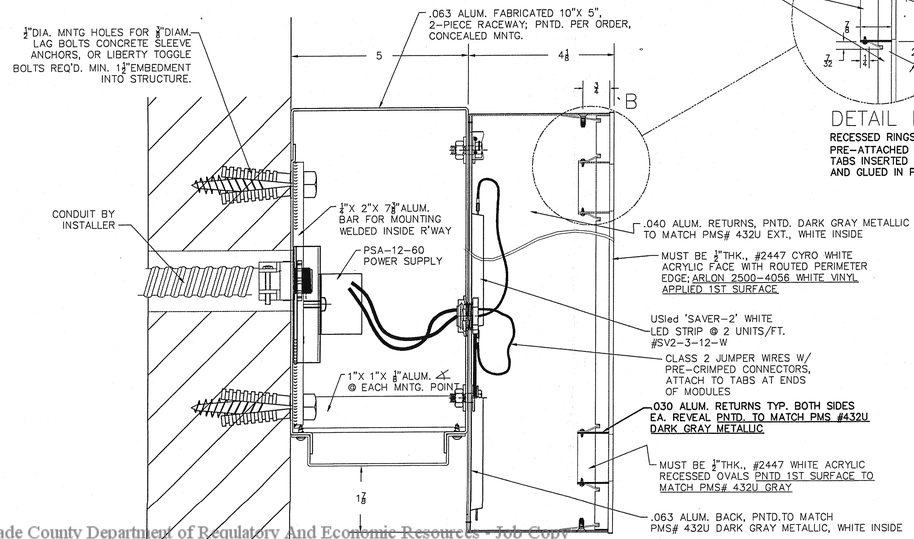

SECTION A-A
TRI-OVAL LOGO FACE DETAIL

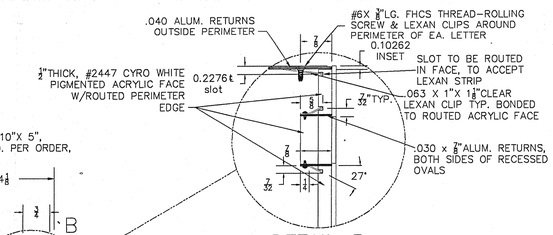

DETAIL B
RECESSED RINGS AND .030 RETURNS PRE-ATTACHED TO (PRE BENT) GLUE TABS INSERTED INTO POCKETS IN FACE AND GLUED IN PLACE.

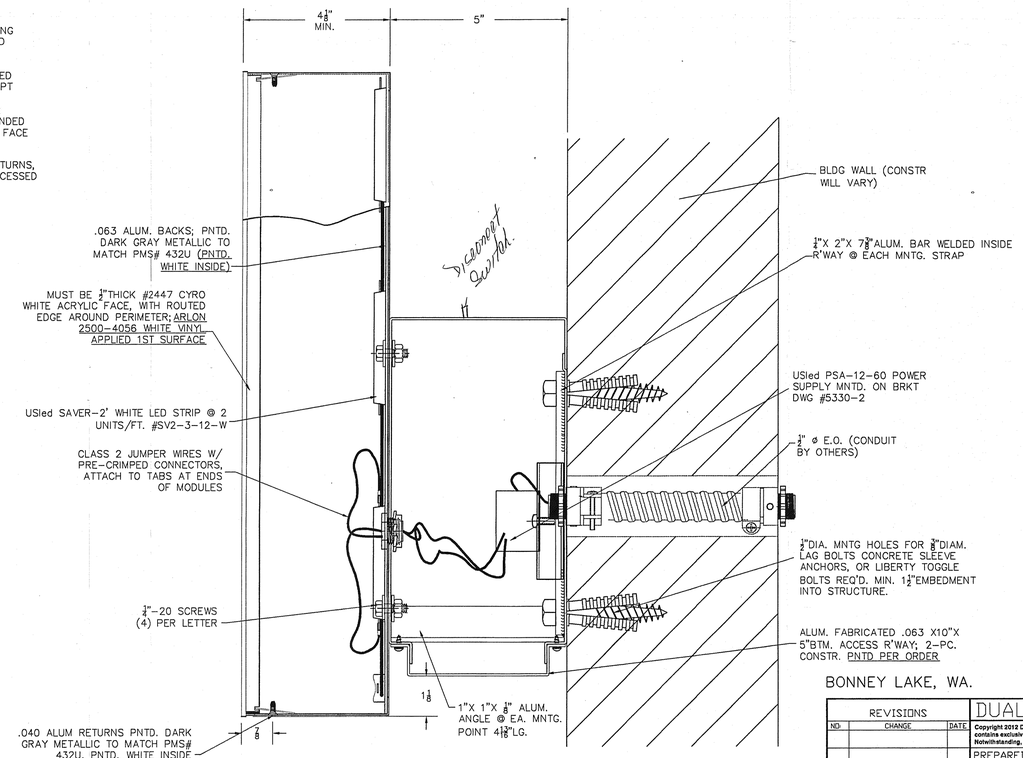

TYP. LETTER SECTION

BONNEY LAKE, WA.

ELECTRICAL REQUIRED

PSA-12-60 POWER SUPPLY #1
45 UNITS @ 22'-6"LG.
AMPS: .63
WATTS: 29.7
U.L.: STANDARD

PSA-12-60 POWER SUPPLY #2
41 UNITS @ 20'-6"LG.
AMPS: .63
WATTS: 27.06
U.L.: STANDARD

PSA-12-60 POWER SUPPLY
MIN.=8'/MAX.=45'; THIS LED TYPE

TOTAL ELECTRICAL REQ'D.

PSA-12-60 POWER SUPPLIES (2)
86 UNITS @ 43'-0"LG.
AMPS: 1.26
WATTS: 56.76
U.L.: STANDARD

2012 LOGO W/TRI-OVAL

REVISIONS			DUALITE, INC.- WILLIAMSBURG, OH.
NO	CHANGE	DATE	

Copyright 2012 Dualite Sales & Service, Inc. - All Rights Reserved - This drawing was created by Dualite Sales & Service, Inc. and contains exclusive design and manufacturing elements executed by Dualite and may not be reproduced without Dualite's consent. Notwithstanding, Dualite claims no intellectual property rights to the individual logos that appears in this document.

PREPARED FOR: SHOP USE ONLY	
MODEL: STATE FARM 21 5/16"X 32 13/16"TRI-OVAL, 20"INDIV. USled SAVER2 WHITE LED ILLUN. LTRS. ON BTM. ACCESS R'WAY	
SCALE: 1"= 1'-0"	CHECKED BY: BA 12/10/12
DATE: 12/10/12	DRAWN BY: MTH
SHEET NO: 254F5	DRAWING NO: 4072

Miami Dade County Department of Regulatory And Economic Resources - Job Copy
0000716780 - 4/17/2013 12:38:16 PM
SHEET1-03252013.PDF

Examiner	Date Time Stamp	Disp.	Trade	Stamp Name
Carlos Labiste	3/28/2013 4:02:32 PM	I	STRU	Aluminum in conctere
Jose Borbolla	3/26/2013 2:48:53 PM	A	ZONE	Approved
Steven Gilbert	3/27/2013 9:03:07 AM	P	ELEC	Approved As Noted
Carlos Labiste	3/28/2013 4:02:28 PM	A	STRU	Approved
Steven Gilbert	4/9/2013 10:24:34 AM	V	ELEC	Void