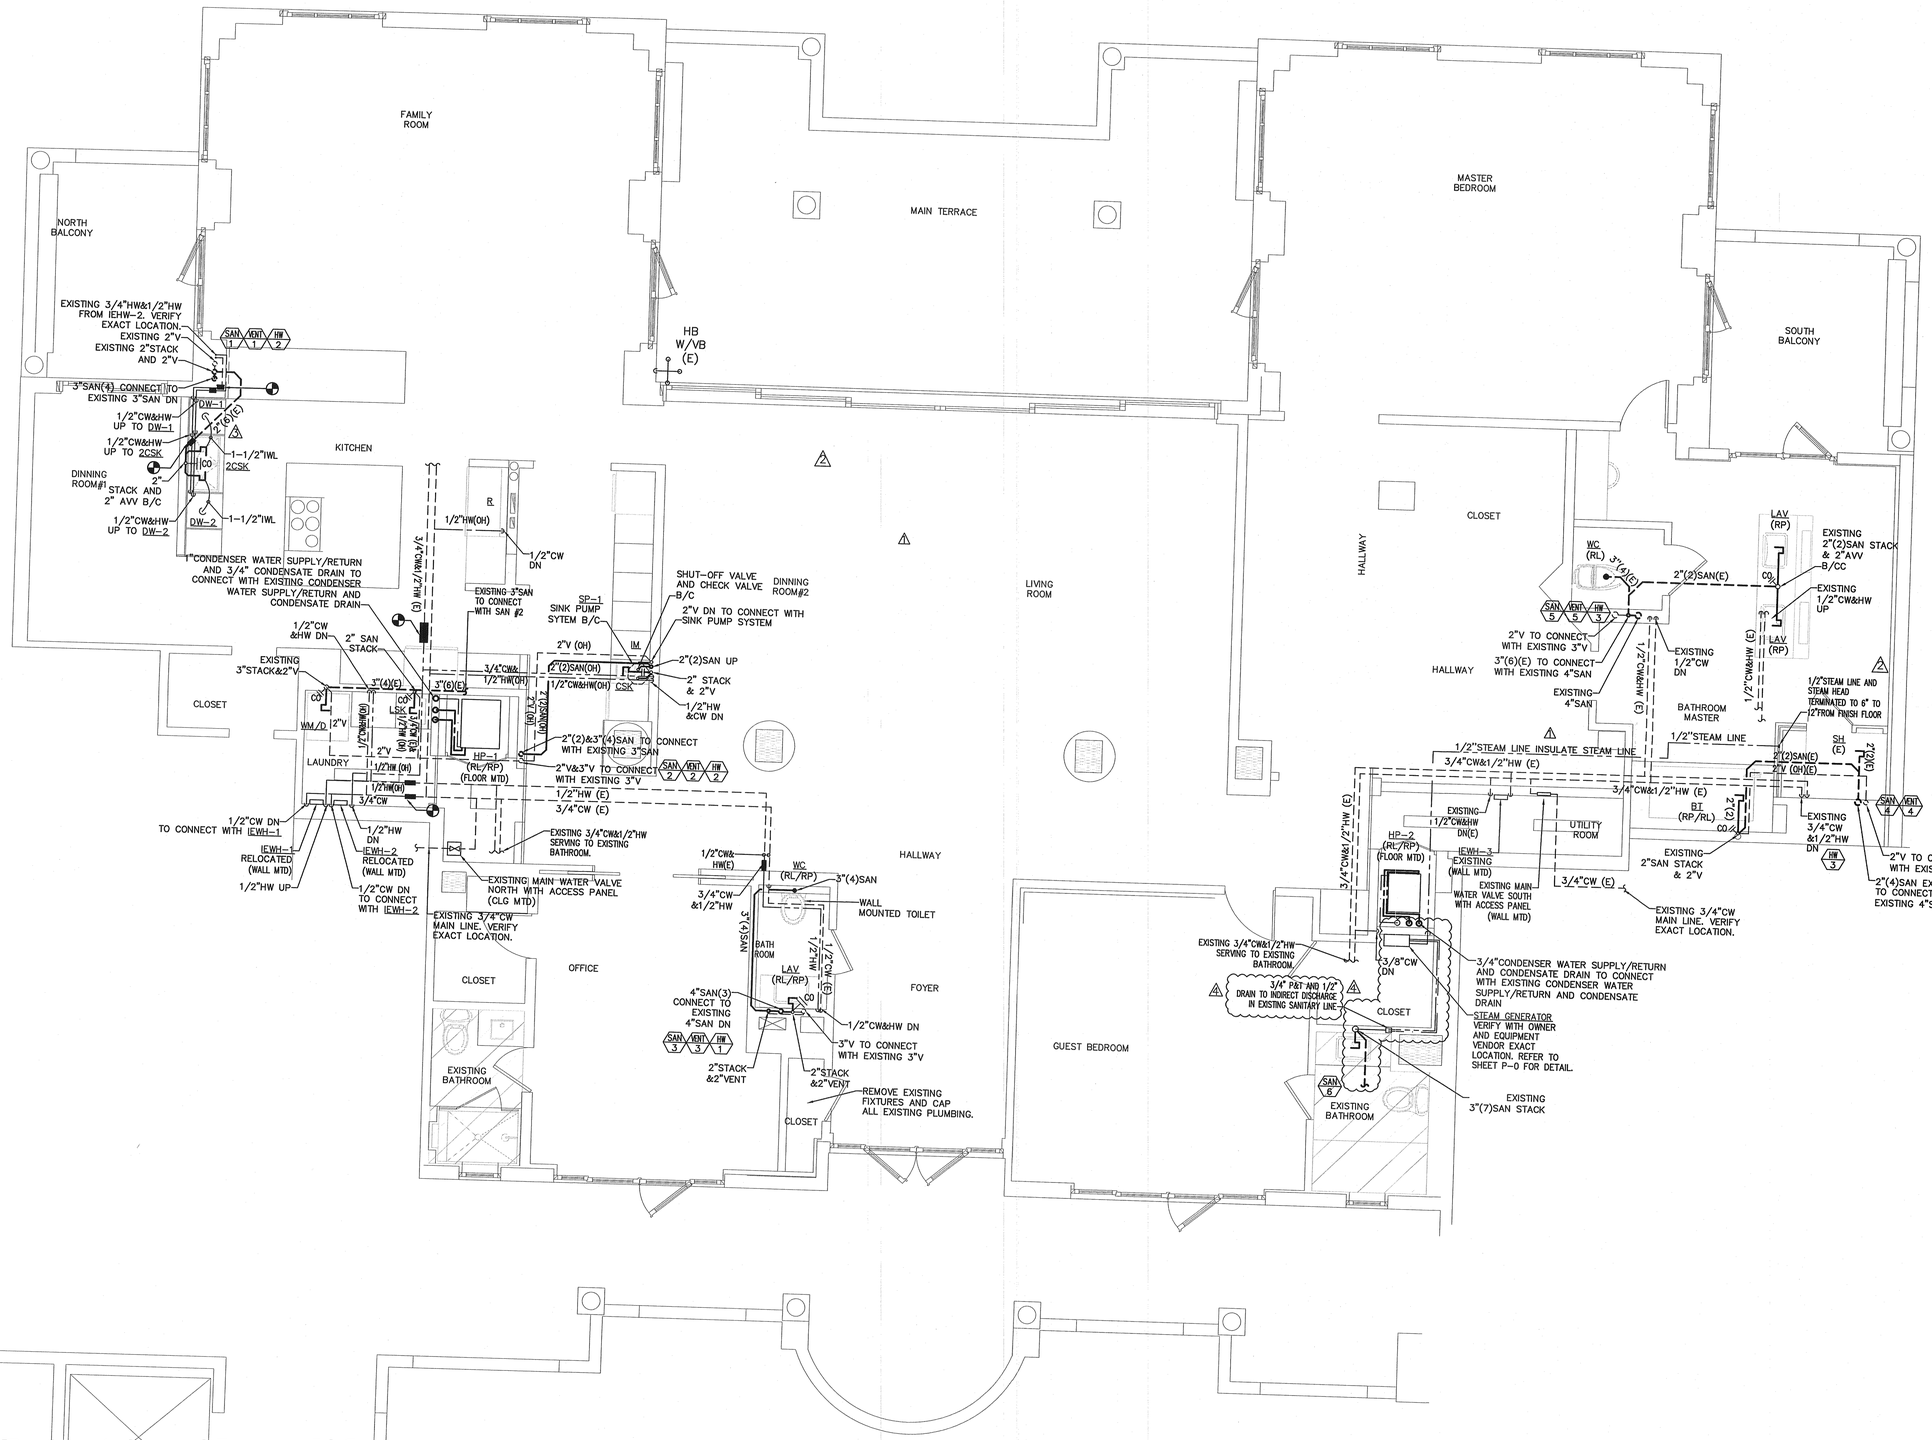

N

Plumbing Floor Plan

Scale: 1/4" = 1' - 0"

Miami Dade County Department of Regulatory And Economic Resources - Job Copy
0001123882 - 8/25/2016 12:46:25 PM
P-1-07282016.PDF
Examiner Date Time Stamp Disp. Trade Stamp Name
Wilfredo Urquiaga 8/1/2016 9:00:16 AMP PLUM Approved As Noted

atelier
space planning
CERTIFIED GENERAL CONTRACTOR
9490 NW 58 st. # 104 Doral FL 33178
305.954.8842 - tel/ fax 305.716.7150
atelier@comcast.net

PROJECT NUMBER (1125) 2016

OWNER
REICH RESIDENCE

ADDRESS
7872 FISHER ISLAND DRIVE
FISHER ISLAND FL, 33109

DRAWN
S.C

PJV ENGINEERING, INC.
Mechanical & Electrical Engineers
Tel: (305) 742-2112
C.A.# 25987
email: info@pjveng.com
www.pjveng.com

DATE
05/01/2016

SCALE
SCALE: AS SHOWN

SHEET DESCRIPTION
PLUMBING FLOOR PLAN

REVISIONS

1	BLDG. DEPT	04/11/16
2	FIELD REV	06/29/16
3	FIELD REV	07/20/16
4	FIELD REV	07/27/16

PABLO J. VITERI
PE# 59535
JUL 27 2016

SEAL

SHEET NUMBER
P-1