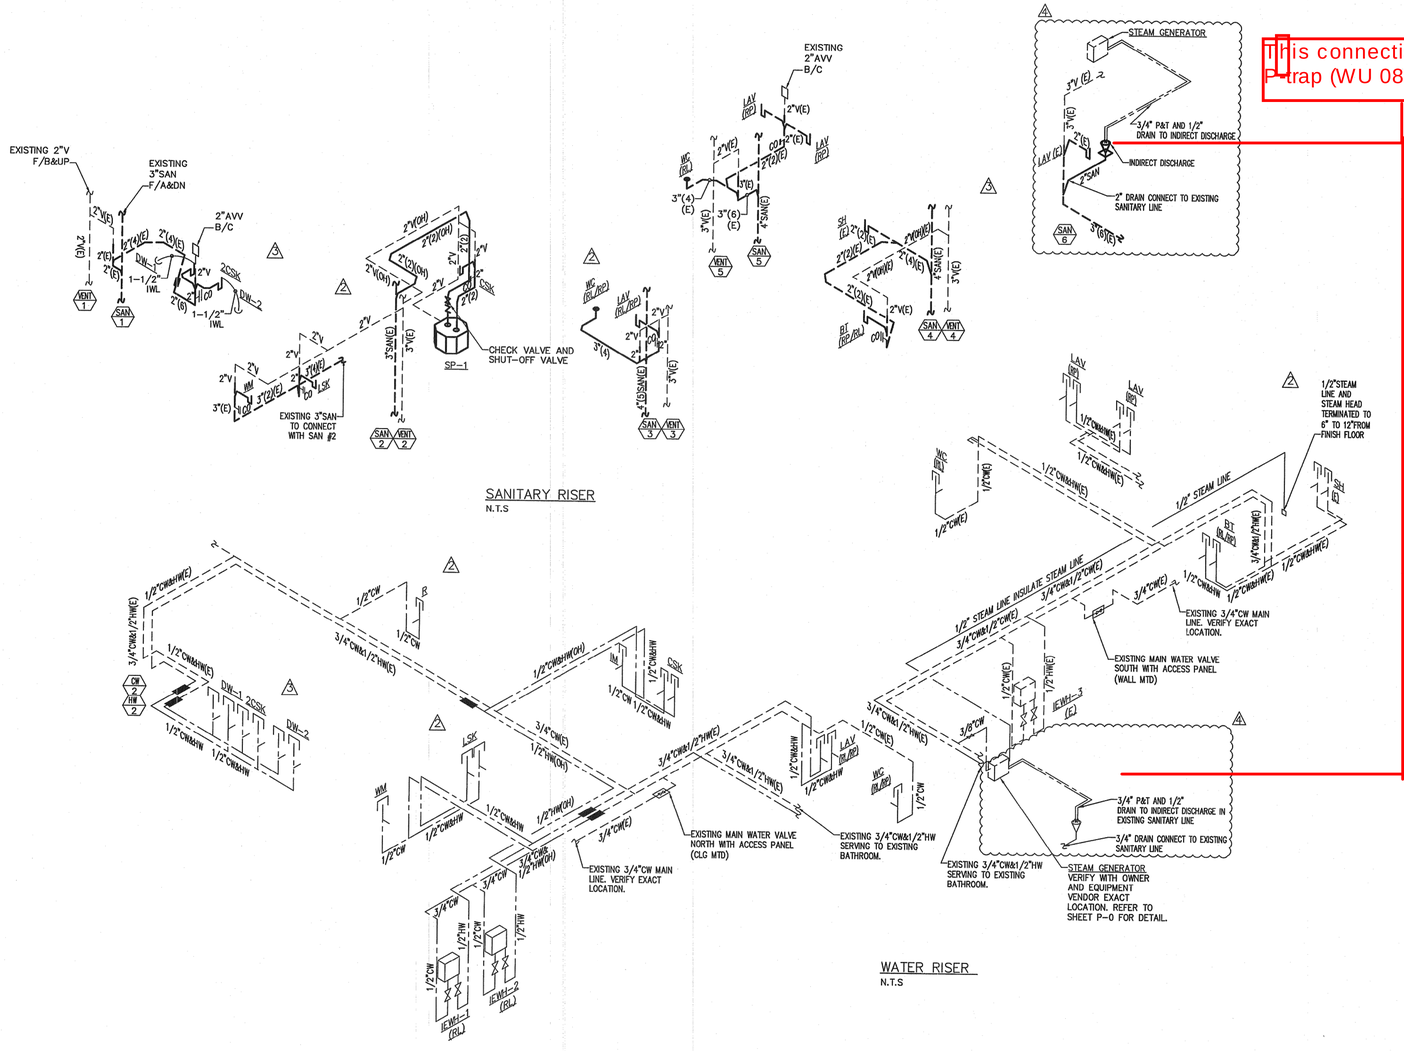

This connections requires P-trap (WU 08.01.16)

SANITARY RISER
N.T.S

WATER RISER
N.T.S

atelier
space planning
CERTIFIED GENERAL CONTRACTOR
9450 NW 58 st. # 104 Doral, FL. 33178
305.594.0042 - tel/fax 305.715.7850
ateliercf@comcast.net

PROJECT NUMBER (1125) 2016

OWNER
REICH RESIDENCE

ADDRESS
7872 FISHER ISLAND DRIVE
FISHER ISLAND FL, 33109

DRAWN
S.C

PJV ENGINEERING, INC.
Mechanical & Electrical Engineers
Tel: (305) 742-2112
C.A.# 25987
email: info@pjveng.com
www.pjveng.com

DATE
05/01/2016

SCALE
SCALE: AS SHOWN

SHEET DESCRIPTION
PLUMBING RISER PLAN

REVISIONS
1 BLDG. DEPT 04/11/16
2 FIELD REV 06/29/16
3 FIELD REV 07/20/16
4 FIELD REV 07/27/16

PABLO J. VITERI
PE# 59535
JUL 27 2016

SEAL

SHEET NUMBER
P-2

Miami Dade County Department of Regulatory And Economic Resources - Job Copy
0001123882 - 8/25/2016 12:46:25 PM
P-2-07282016.PDF

Examiner	Date Time Stamp	Disp.	Trade	Stamp Name
Wilfredo Urquiaga	8/1/2016 8:57:32 AM	P	PLUM	Approved As Noted